


- NOTES:
1. ONLY USE FULLY INSULATED FEMALE QUICK DISCONNECT TERMINALS.
  2. ALL SPARES SHALL BE IDENTIFIED WITH LABEL AND ENDS TAPED OR INSULATED.
  3. SPARE WIRE LABELS SHALL BE SECURED SO THEY DO NOT SLID OFF.
  4. WIRES SHOULD HAVE NO TENSION.

| SSS  |      |   |          |          |
|------|------|---|----------|----------|
| ZONE | REV. | DESCRIPTION                                 | DATE     | APPROVED |
|      | 0    | AS-BUILT RE-CREATION RELEASE PER DRD-220601 | 07/28/22 |          |



KCD4 AB3

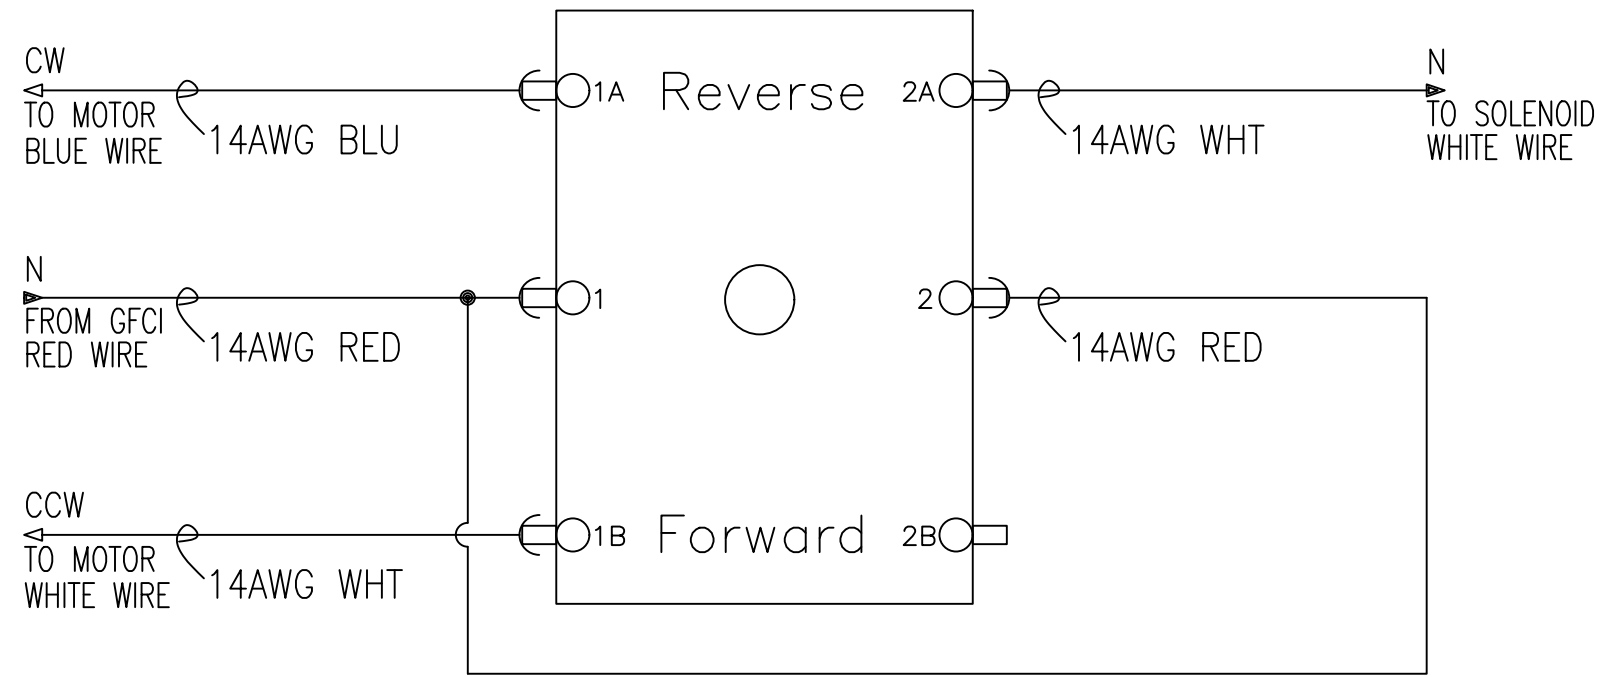

PROPRIETARY AND CONFIDENTIAL  
 THE INFORMATION CONTAINED IN THIS DRAWING IS THE SOLE PROPERTY OF MUDMIXER. ANY REPRODUCTION IN PART OR AS A WHOLE WITHOUT THE WRITTEN PERMISSION OF MUDMIXER IS PROHIBITED.

|  |             | UNLESS OTHERWISE SPECIFIED                     |  | NAME      | DATE |
|--|-------------|--|--|-----------|------|
|  |             | DIMENSIONS ARE IN INCHES                       |  | DRAWN     | AA   |
|  |             | TOLERANCES:                                    |  | CHECKED   |      |
|  |             | FRACTIONAL ±                                   |  | ENG APPR. |      |
|  |             | ANGULAR: MACH ± BEND ±1.0°                     |  | MFG APPR. |      |
|  |             | TWO PLACE DECIMAL ±0.03                        |  | Q.A.      |      |
|  |             | THREE PLACE DECIMAL ±0.015                     |  | COMMENTS: |      |
|  |             | FOUR PLACE DECIMAL ±0.003                      |  |           |      |
|  |             | INTERPRET GEOMETRIC TOLERANCING PER ASME Y14.5 |  |           |      |
|  |             | MATERIAL                                       |  |           |      |
|  | MUDMIXER    | SEE PARTS LIST                                 |  |           |      |
|  |             | FINISH   |  |           |      |
|  | NEXT ASSY   | USED ON  |  |           |      |
|  |             | SEE NOTES                                      |  |           |      |
|  | APPLICATION | DO NOT SCALE DRAWING                           |  |           |      |

**MUDMIXER.com**

TITLE: MUDMIXER 120VAC SWITCH WIRING

SIZE DWG. NO. US07282022 REV 0

SCALE: 1:1 WEIGHT: SHEET 1 OF 1